


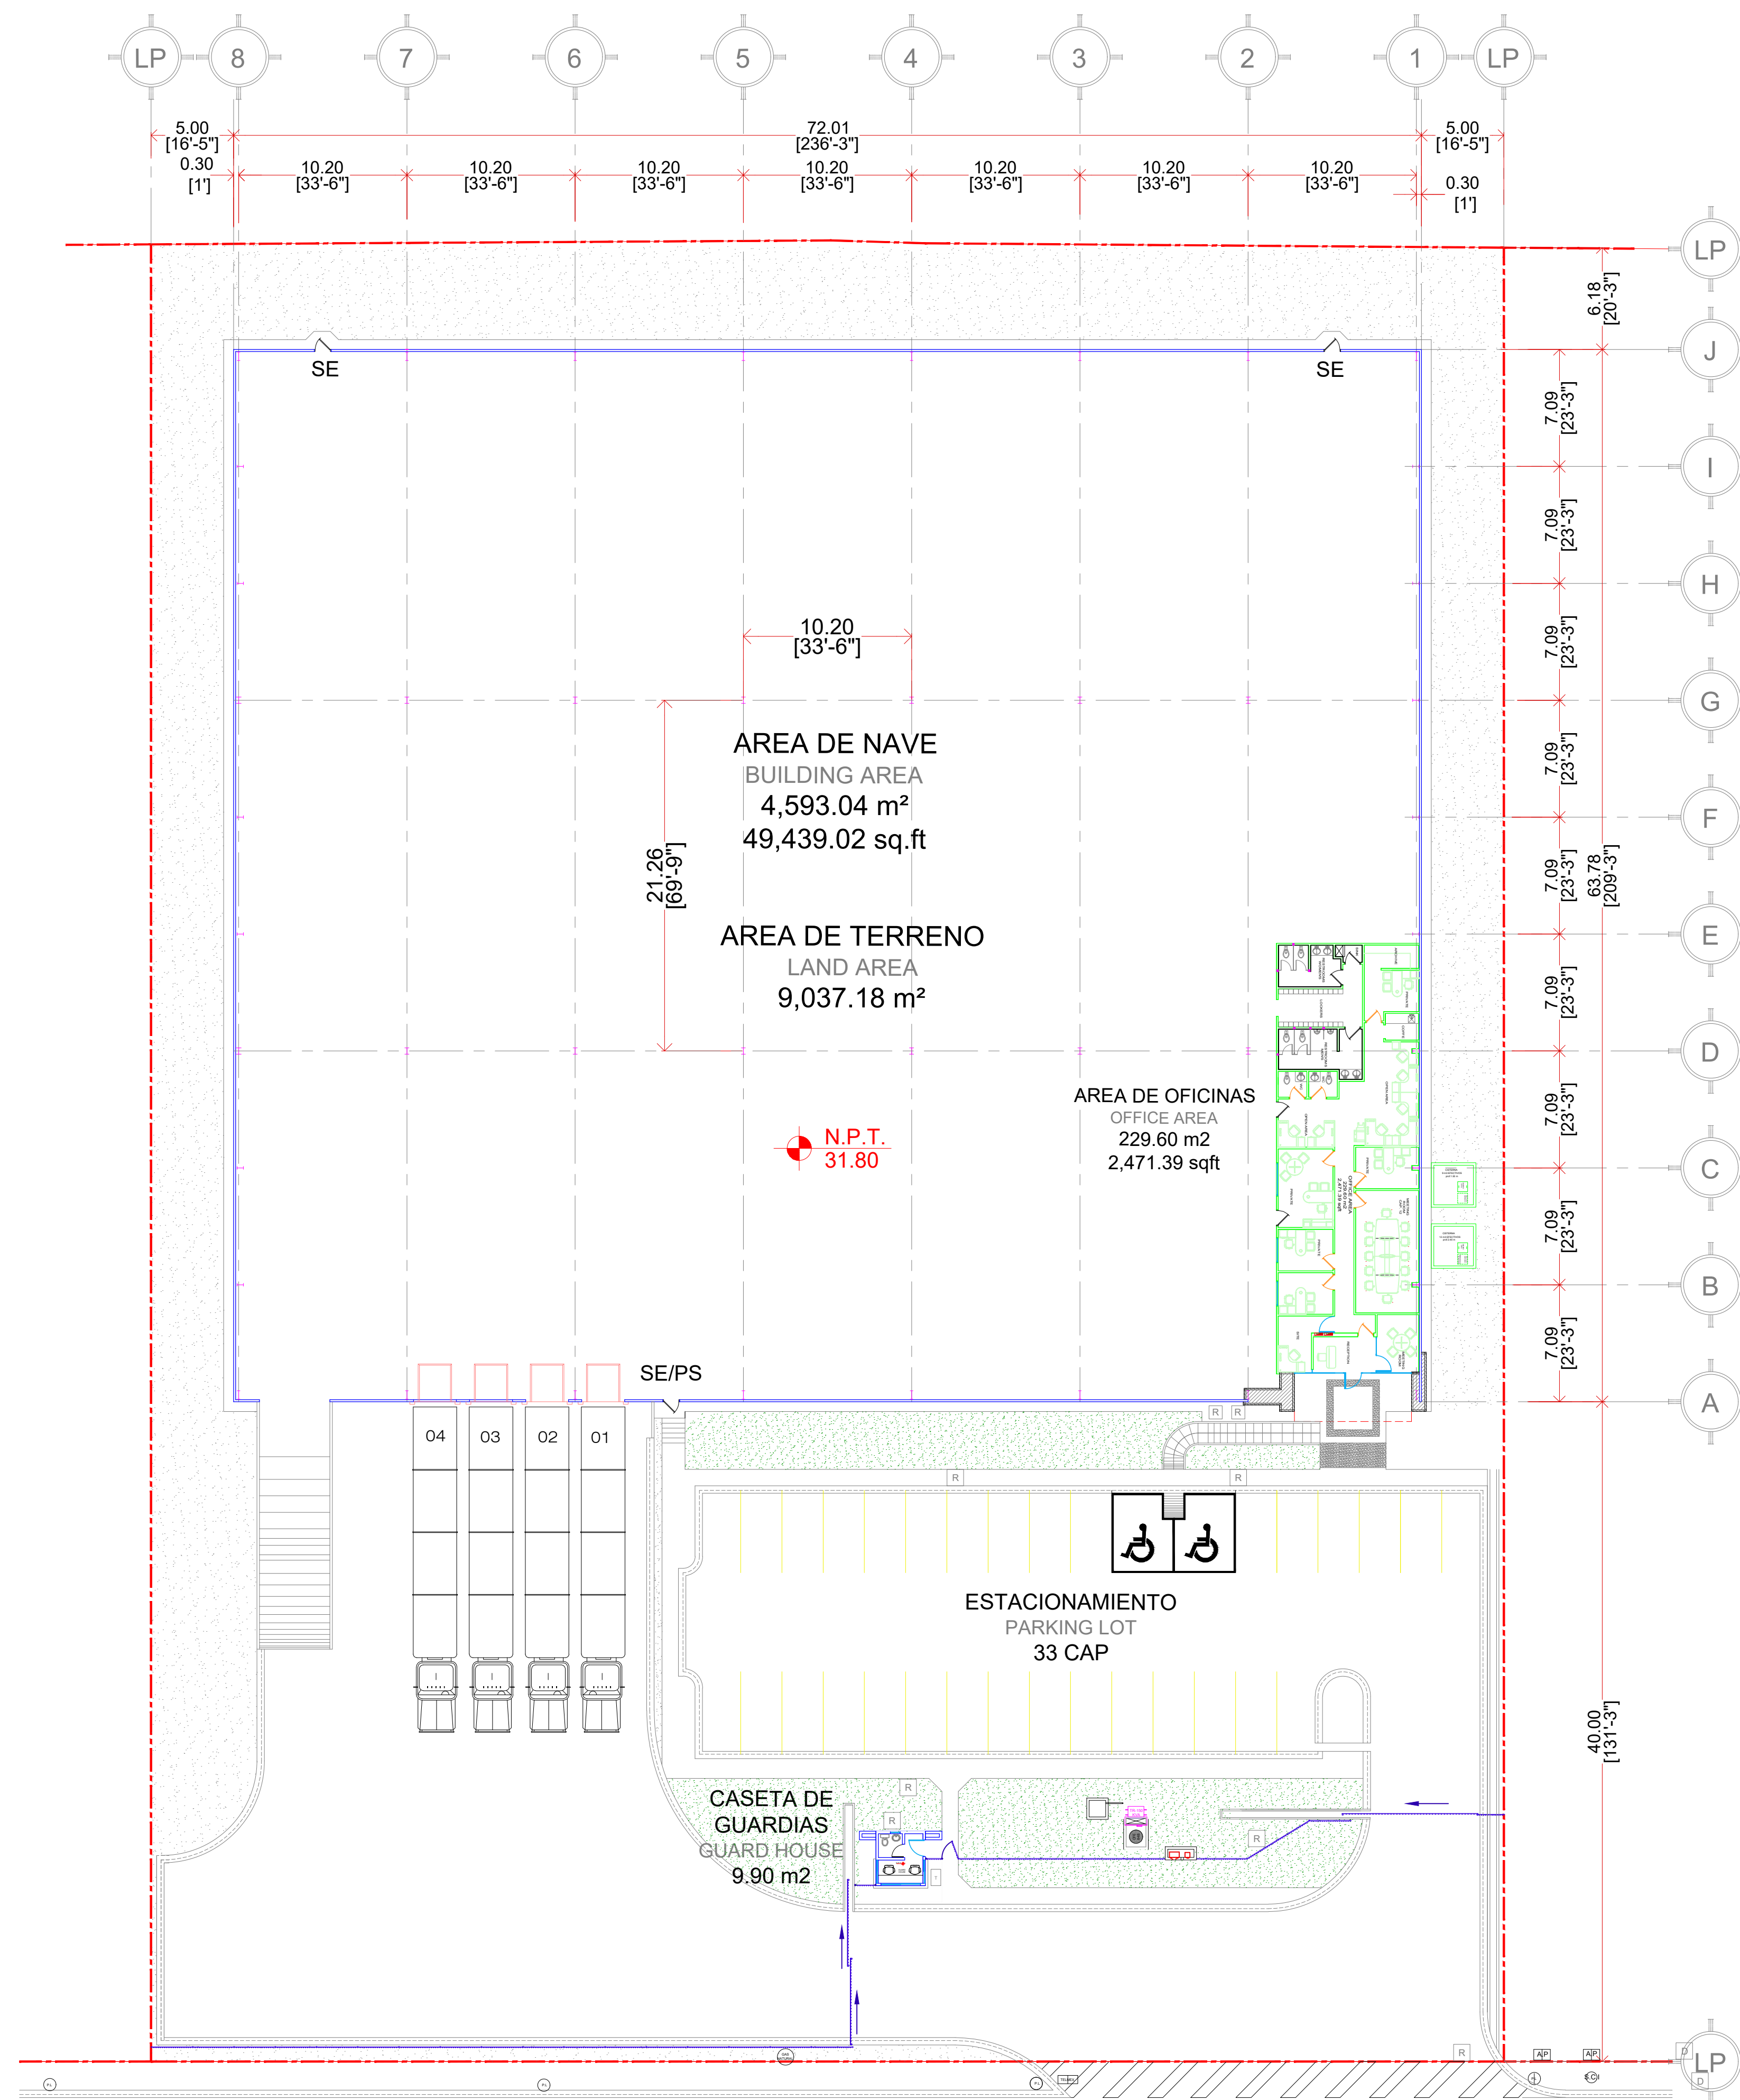

NOTES:	DRAWING	REFERENCE	No.	REV. DATE	DESCRIPTION OF REVIEW	DRAWN:	F.G.R.	 VYNMSA CONSTRUCTION & DEVELOPMENT HUMBERTO LOBO #520 - LOCAL 186, COL. DEL VALLE SAN PEDRO GARZA GARCIA N.L. MEXICO	DIMENSIONS: METROS	PROJECT: CORRUEMPAQUES		
			0	DEC 15th, 2014	AS BUILT	PROYECTED:			SCALE: S/E	TITLE: PLANTA ARQUITECTONICA ARQUITECTURAL LAYOUT		
			1			REVIEWED:			DATE: 15_DEC	AREA:	No. OF DRAWING:	REV:
			2			APPROVED:			CE-AR-02			
			3			COORDINED:						
			4									